

**SCDHEC OFFICE OF OCEAN AND COASTAL RESOURCE MANAGEMENT  
PERMIT APPLICATION PUBLIC NOTICE**

**November 21, 2008**

**Permit Number:** OCRM-08-555-A  
**Permit ID:** 65010

The SCDHEC Office of Ocean and Coastal Resource Management has received an application for a permit for the alteration of a critical area. This application was submitted pursuant to the Coastal Zone Management Act (Act 123) of the 1977 South Carolina General Assembly. The application, in brief, is described as follows:

**APPLICANT:** Barbara B Shelley  
c/o Hoyt Sanderson  
2450 Red Bluff Rd.  
Loris SC 29569

**LOCATION:** On and adjacent to Hog Inlet at 335 46th Ave N, North Myrtle Beach, Horry County, South Carolina.  
TMS#: 145-02-15-035.

**WORK:** The work, as proposed and shown on the attached plans consists of constructing a replacement bulkhead. Specifically, the applicant seeks to remove the existing wall and replace it with a new 50' long bulkhead. The purpose of the proposed activity is for erosion control.

This public notice is being distributed to all known interested persons and agencies to assist in developing facts on which a decision by OCRM can be based. Comments concerning the proposed work should be submitted in writing, setting forth sufficient detail to furnish a clear understanding of the reasons for support or opposition.

The decision to issue or deny a permit will be based on the individual merits of the application, the policies specified in the South Carolina Coastal Zone Management Act, and the considerations outlined in the State of South Carolina Coastal Zone Management Program. Interested parties who wish to be notified of final permit action must notify OCRM in writing of this request.

*To assure review by OCRM, comments regarding this application must be received by OCRM on or before December 6, 2008. For further information please contact the project manager for this activity, Tanitra S. Marshall at 843-238-4528.*

**PLEASE REPLY TO:**

SCDHEC OFFICE OF OCEAN AND COASTAL RESOURCE MANAGEMENT  
927 Shine Avenue  
Myrtle Beach, South Carolina 29577

**Please refer to P/N# OCRM-08-555-A**



\_\_\_\_\_  
Tanitra S. Marshall, Project Manager

STATE OF SOUTH CAROLINA  
HORRY COUNTY

I, JACK F. DAVIS HEREBY STATE THAT TO THE BEST OF MY KNOWLEDGE, INFORMATION, AND BELIEF THE SURVEY AS SHOWN HEREON WAS MADE IN ACCORDANCE WITH THE MANUAL STANDARDS MANUAL FOR THE PRACTICE OF LAND SURVEYING IN SOUTH CAROLINA AND MEETS OR EXCEEDS THE REQUIREMENTS FOR A CLASS A SURVEY AS REQUIRED THEREIN.




Jack F. Davis  
JACK F. DAVIS P.L.S. # 4779  
1878 SIMPSON GREEN DR.  
LONGS S.C. 29569

NOTE: THIS IS A RESURVEY OF AN EXISTING PARCEL


TOM HUDSON  
& SHARI HUDSON  
TMS 145-02-15-036  
D.B. 1981 PG. 127  
LOT 37

DONALD L. SWAN  
& GRETCHEN SWAN TRUSTEES  
TMS 145-02-15-034  
D.B. 2004 PG. 1410  
LOT 35


46TH AVENUE NORTH  
50' R/W  
ASBUILT SURVEY FOR  
**BARBARA B. SHELLEY**  
NORTH WATTLE BEACH  
SOUTH CAROLINA  
SCALE 1" = 20'  
GRAPHIC SCALE  
LITTLE RIVER TWP.  
NOVEMBER 8, 2008

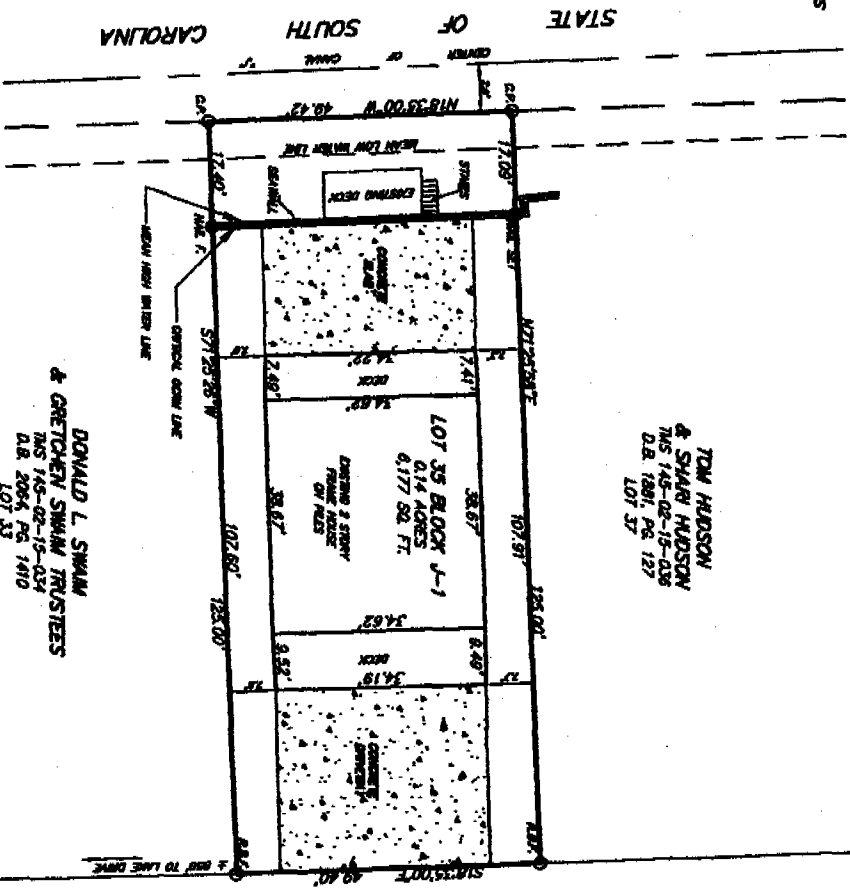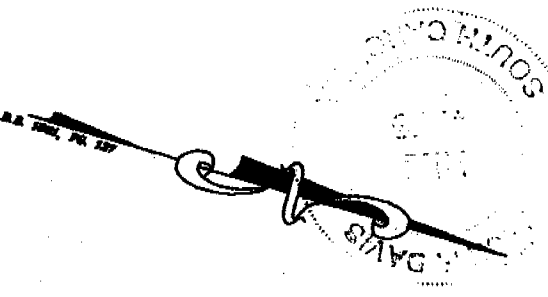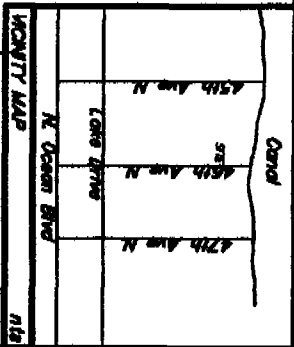

- NOTES:
- 1) THIS PARCEL IS LOCATED IN FLOOD ZONE AE 14 AS SHOWN ON PANEL NO. 4503000014 DATED AUGUST 23, 1989 - FEDERAL INSURANCE ADMINISTRATION FLOOD INSURANCE RATE MAPS.
  - 2) PRESENT TAX MAP NO. TMS 145-02-15-035
  - 3) DATE OF FIELD SURVEY: NOVEMBER 8, 2008
  - 4) THIS PROPERTY IS SUBJECT TO ANY AND ALL EASEMENTS AND/OR RIGHT-OF-WAYS OF RECORD.
  - 5) OWNER OF RECORD: BARBARA B. SHELLEY
  - 6) LAND USE: RESIDENTIAL
  - 7) TOTAL ACRES: 0.14 ACRES
  - 8) NO S.C. MONITORING, GEODETIC CONTROL, FILLED WITHIN 2000'
  - 9) REFERENCE: DEED BOOK 1059 PAGE 128

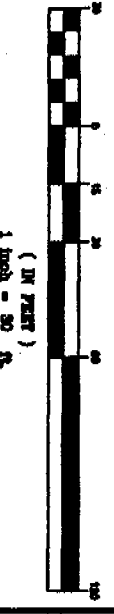

# Proposed Site Plan

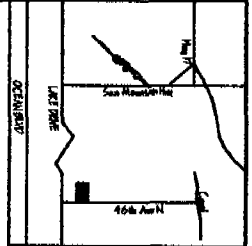


VICINITY MAP  
NOT TO SCALE

Reference:  
Survey by C.D. Barn  
Surveying, Dated 2/17/97


145-02-15-036  
Lot 36 Block J1  
Tom & Sheri Hudson  
Db. 1881 Pa. 127

145-02-15-034  
Lot 34 Block J1  
Donald & Gretchen Swann  
Db. 2064 Pa. 140

FLOOD NOTE:  
THE SUBJECT PROPERTY SHOWN  
HEREON DOES NOT LIE IN AN AE 1% ZONE  
SPECIAL FLOOD HAZARD AREA  
PER FEMA PLANS & ASSOCIATION  
DATED 8-23-88

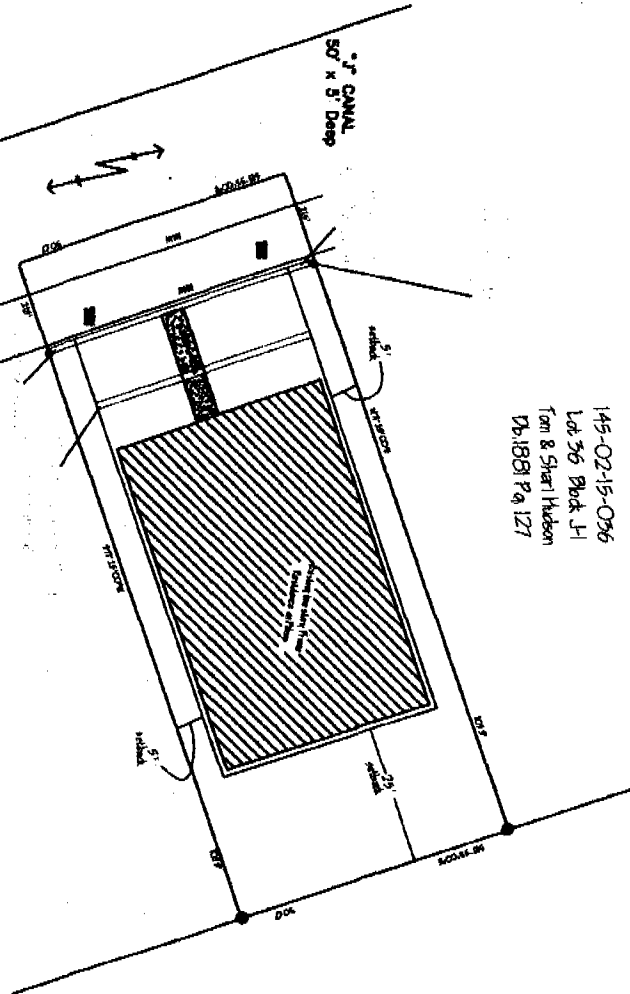

46th Ave. N. (50' R/W)

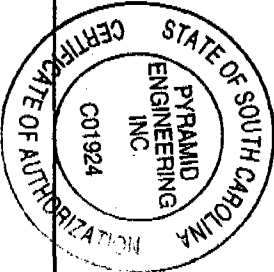

- NOTES:
1. THIS IS A PROPOSED SITE PLAN AND SHALL NOT BE CONSIDERED TO PERMIT THE LOCATION, DESIGN, OR ESTABLISHMENT OF RESTRICTIONS OR PROPERTY LINES OR DESCRIPTIONS OF ANY CONSTRUCTION TO ANY OTHER PARTY.
  2. ALL CONSTRUCTION SHALL BE IN ACCORDANCE WITH THE ZONING ORDINANCES AND RESTRICTIONS BEFORE STRUERS.
  3. R/W = RIGHT OF WAY
  4. DR = EXISTING ROAD RIGHT-OF-WAY
  5. DR = EXISTING ROAD RIGHT-OF-WAY
  6. DR = EXISTING ROAD RIGHT-OF-WAY
  7. THIS IS A SITE PLAN OF AN EXISTING PARCEL OF LAND.
  8. SERVICES PER ZONING
  9. THIS # 145-02-15-036
  - 10.

SHELLEY RESIDENCE


Plan of property is the property of Pyramid Engineering, Inc. and may not be used in whole or part without written consent.

Barbara A. Shelley  
46th Avenue N.  
N. Myrtle Beach, SC 29582  
(843) 333-3917

Lot: 34 Block J1	Sheet No: 1 of 2
Prepared by: [Signature]	Date: [Date]
Check Address: 46th Avenue N.	City/State/Zip: N. Myrtle Beach, SC 29582
City/State/Zip: N. Myrtle Beach, SC 29582	Date: 10/19/08

PLAT NO. 40


PLAT NO. 40

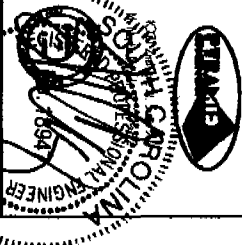

10/24/08

Not to Scale



## Section Thru Sheet Pile

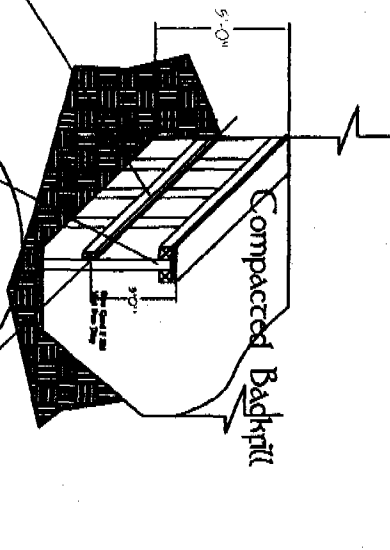

**CDacris Inc. International, Inc.**

or approved equal

**CDacrisia Incarnatorum** Inc.

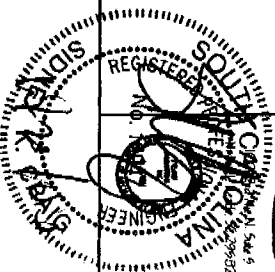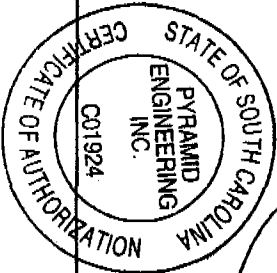

SHELLEY RESIDENCE

This drawing is the property of Pyramid Engineering, Inc. and may not be used in whole or part without written consent.

Barbara A. Shelley  
46th Avenue N.  
N. Myrtle Beach, SC 29582  
(843) 333-3917

Leaf: 29 Pack: 11	Sheet No: 2 of 2
Designator:	Sub: 44
Street Address: 4501 Ave	City: 19
City/State/Zip: N. Myrtle Beach, SC 29582	Date: 10/19/08
Plot Name: 44	Plot Number: 44